

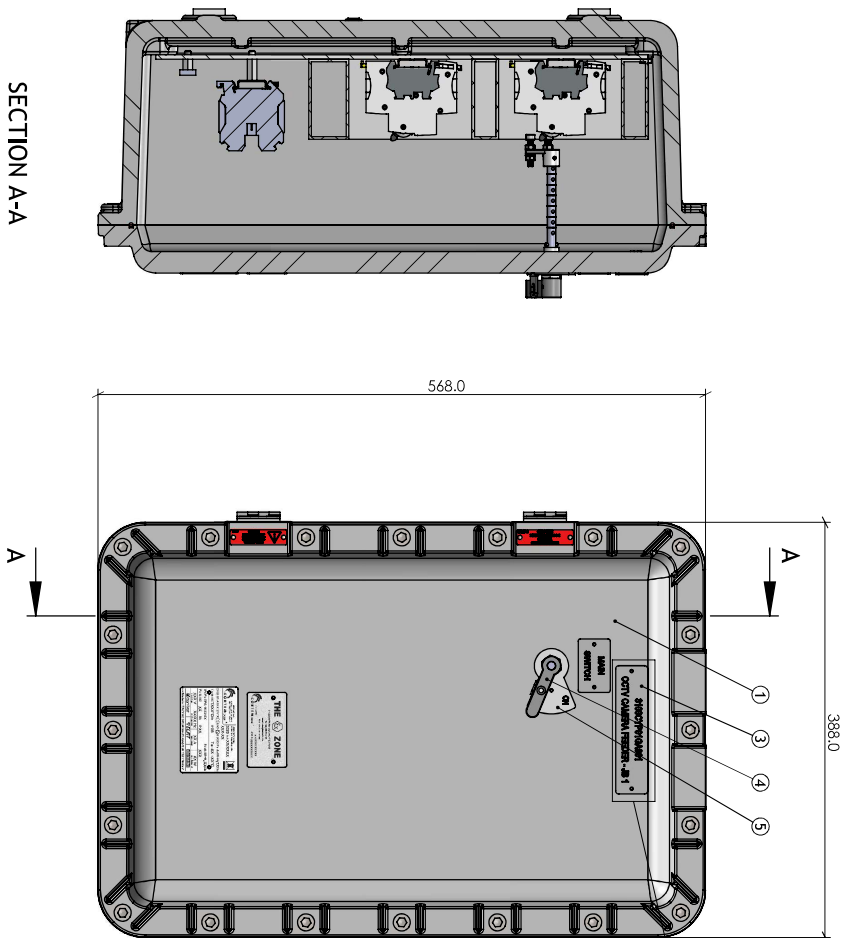
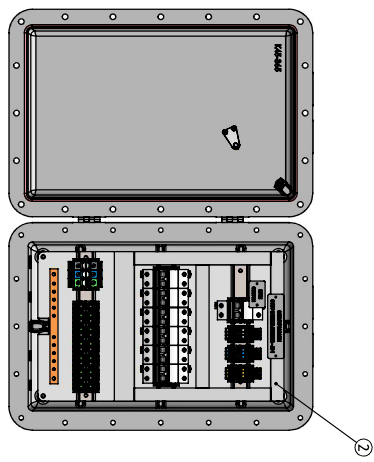


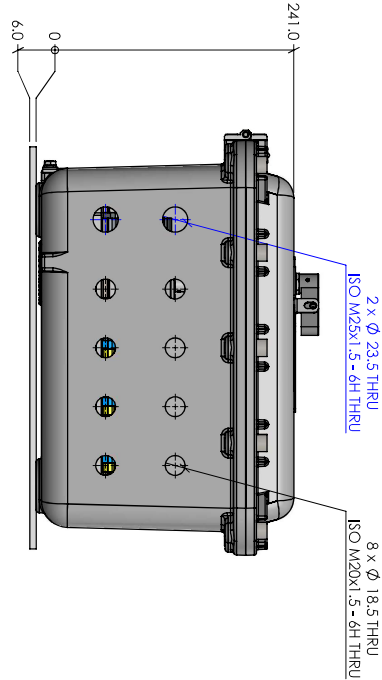

FOR EACH ENCLOSURE	
3100CYPVIGLA001	CCTV CAMERA FEEDER - JB 1
3200CYPVIGLA001	CCTV CAMERA FEEDER - JB 2
3800CYPVIGLA001	CCTV CAMERA FEEDER - JB 4
3800CYPVIGLA001	CCTV CAMERA FEEDER - JB 5
3700CYPVIGLA001	CCTV CAMERA FEEDER - JB 6
3800CYPVIGLA001	CCTV CAMERA FEEDER - JB 7
3700CYPVIGLA002	CCTV CAMERA FEEDER - JB 8
3800CYPVIGLA001	CCTV CAMERA FEEDER - JB 9

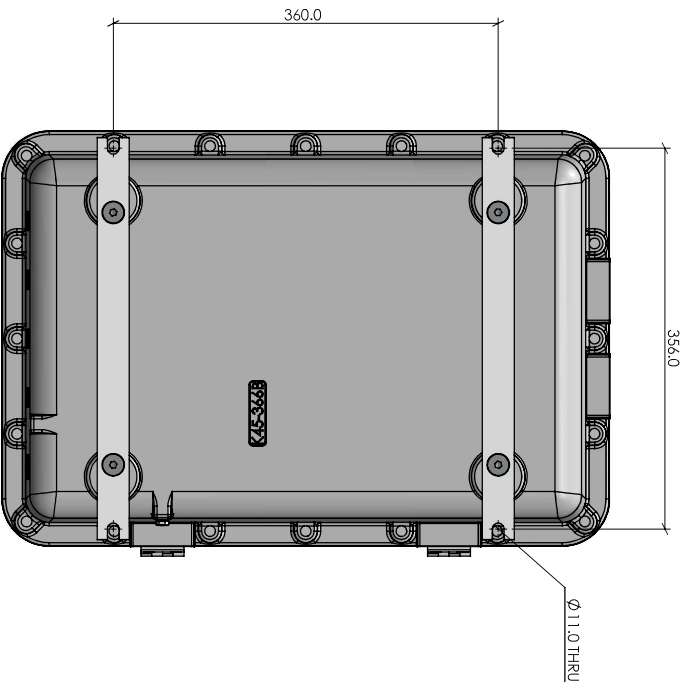

SECTION A-A

• UNLESS OTHERWISE SHOWN, REFER TO CUSTOMER REFERENCE DOCUMENTS ON FRONT SHEET FOR INTERVALS/BOM.

REV	DATE	PREPARED	APPROVED	NOTES
0	26/11/2024	JM	AC	Issued for Approval
1	28/11/2024	JM	AC	Issued for Manufacturer
2	04/12/2024	JM	AC	As Built

CONSTRUCTION NOTES

DRAWING NUMBER	DESCRIPTION
EXP-E-JB-45B-002-GA	Zone 1 CCTV 6-Way Distribution Panel - General Assembly

1	2	3	4	5	6	7	8
---	---	---	---	---	---	---	---



1	2	3	4	5	6	7	8
---	---	---	---	---	---	---	---



